THE CONSTRUCTION DOCUMENT SET FOR THIS PROJECT SHALL INCLUDE THIS DRAWING SHEET, & ALL OTHER SHEETS & ASSOCIATED DOCUMENTS LISTED ON THE DRAWING INDEX ON COVER SHEET, & ANY OTHER DOCUMENTATION AS SUPPLIED BY THE ARCHITECT & CONSULTING ENGINEERS. ALL OF THE PROJECT DOCUMENTS REPRESENT AN ALL ENCOMPASSING WHOLE, & SHALL BE USED IN THEIR ENTIRETY FOR BIDDING & CONSTRUCTION PURPOSES

1 AS-BUILT FLOOR PLAN

AS-BUILT PLANS FOR
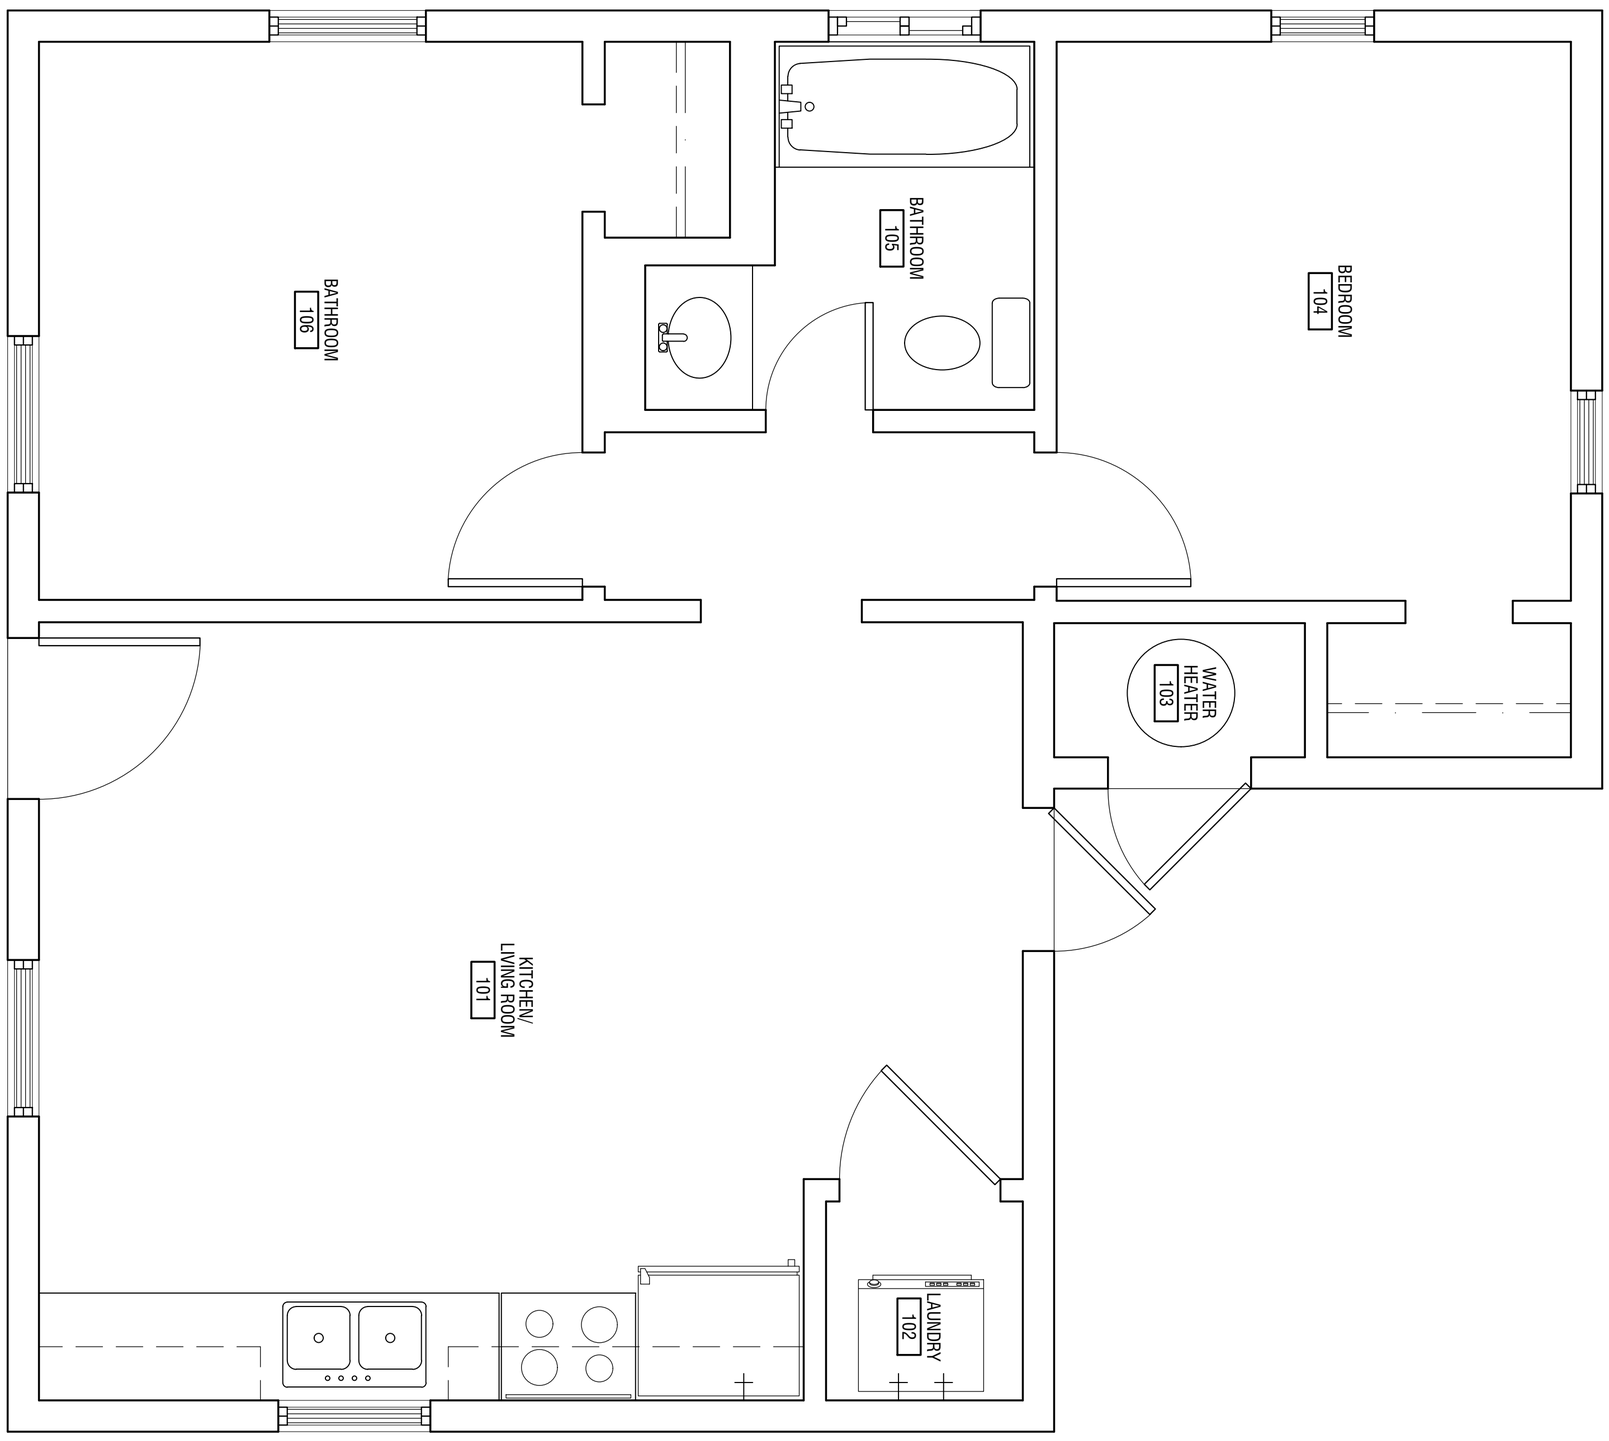
PRESCOTT PINES CAMP - HILLTOP 117